
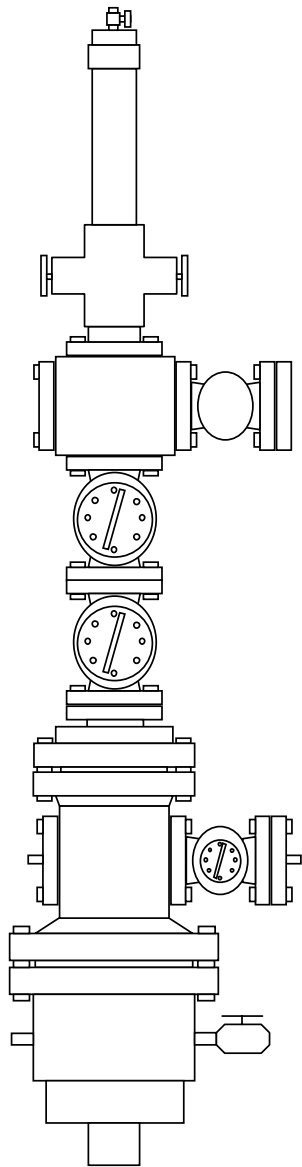


**Current Wellhead Details**

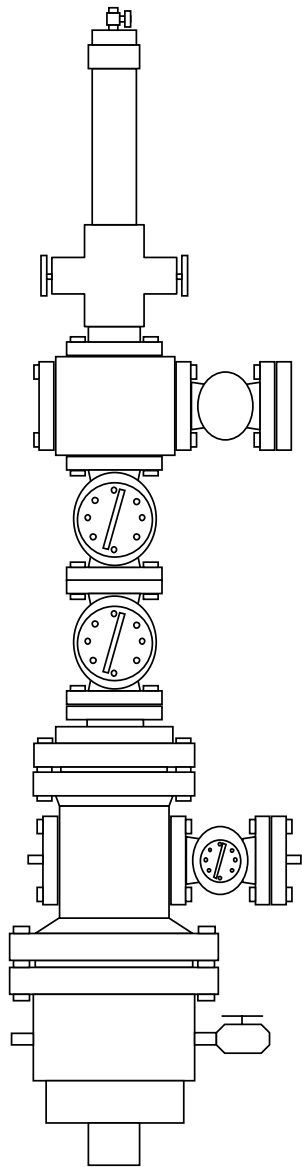

	<b>Cap Assembly</b>		1/2" NPT Needle Valve 2-7/8" x 1/2" NPT Bull Plug 2-7/8" EUE Tubing Collar 2-7/8" EUE J-55 Pup Joint 10'
	<b>Rod BOP</b>	Make/Type Size Rating	JP Ratigan Manual BOP with 1-1/4" Rams 2-7/8" EUE box x 2-7/8" EUE pin 1500psi
	<b>Adapter</b>	Size Rating	2-7/8" EUE box x 2-1/16" API 5k Flange 1500psi x 5000psi
	<b>Wing Valve</b>	Make/Type Size Rating	Wood Group BB 2-1/16" 5000psi
	<b>Flow Cross</b>	Make/Type Size Rating	Wood Group BB 2-1/16" x 2-1/16" x 2-1/16" x 2-1/16" 5000psi
	<b>Master Valve</b>	Make/Type Size Rating	Wood Group BB Gate Valve 2200 Series 2-1/16" x 2-1/16" 5000psi
	<b>Master Valve</b>	Make/Type Size Rating	Wood Group BB Gate Valve 2200 Series 2-1/16" x 2-1/16" 5000psi
	<b>Adapter Flange</b>	Make/Type Size Rating	Wood Group BB 2-1/16" x 7-1/16" 5000psi x 3000psi
	<b>Tubing Spool</b>	Make/Type Size Rating Outlet 1 Outlet 2	CIW Type F 7-1/16" x 11" 5000psi x 3000psi WG Gate Valve 2200 Series 2-1/16" 5000psi Compl Flange 2-1/16" 5000psi with 1-1/2" VR Plug
	<b>Casing Bowl</b>	Make/Type Size Rating Outlet 1 Outlet 2	Wood Group / WG-BP 11" x 9-5/8" LTC bim prep 3000psi 2" NPT Ball Valve 2" NPT Bull Plug tapped 1/2" NPT
	<b>Surface Csg</b>	Sz/Wt/Gr/Thd/Dep	9-5/8" 36# k-55 BTC 1077' RT
	<b>Prodn Csg</b>	Sz/Wt/Gr/Thd/Dep	5-1/2" 17# L-80 LT&C 4357' RT
	<b>Tubing</b>	Sz/Wt/Gr/Thd/Jts	2-3/8" 4.7# J-55 EUE 101
	<b>Tubing Hanger</b>	Make/Type Lift Thd/BPV Prep	CIW FBB-EN 7-1/16" x 2-3/8" 2-3/8" EUE c/w 2" BPV prep
<b>Remarks</b>	No surface casing riser was installed during the initial completion Live annulus, no packer in this well		

Drafted: G Hogan  
Revised: G Hogan Rev 5

Date: 23-June-03  
Date: 19-March-04